

Design report

Canna Sapiens shop

Canna Sapiens shop, Maiselova, Praha 1 · February to April 2026

Example report on a finished project. Drawings and photos are real; acceptance dates and statuses are examples.

Each element of the design next to the photo of what was built on site. Every photo was checked technically by the supervisor before the designer reviewed it.



Concept render



The shop, 27 March 2026


	Element	Status
1	Electrics, as on the plan	Accepted, 10 Mar
2	Blue room with arched niche	Accepted, 24 Mar
3	Counter	Built differently: glass blocks with a wooden top
4	Curved bench	Built, waiting for Rachel
5	Shelves with LED	Accepted

Source: drawings and renders: Rachel Ahuja creative design studio, Canna Sapiens presentation 2026; photos: the build, February to April 2026.

1. Electrics, as on the plan

Accepted, 10 Mar

Whole shop. Panel at the entrance to the back rooms. Sockets and LED strips inside the counter, LED strips in every shelf, TV outlet on the left wall.

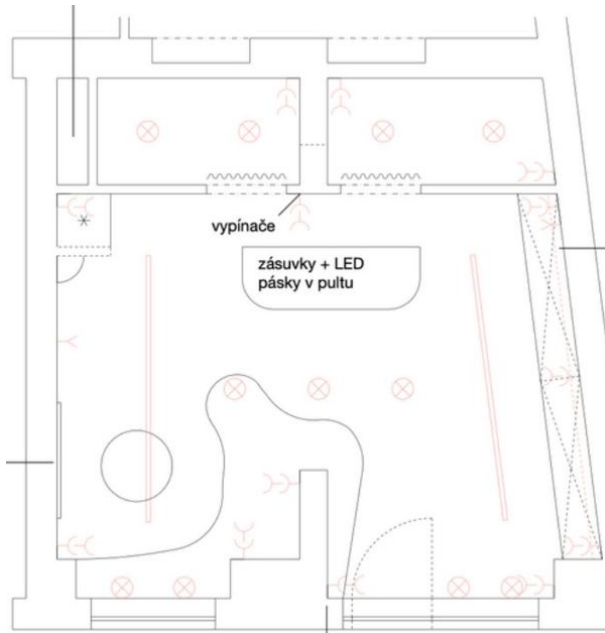

Design



As built


2. Blue room with arched niche

Accepted, 24 Mar

Shop floor. Walls, ceiling and the niche in one deep blue, colour drenching. Round arch niche behind the counter, yellow pendant in front of it.



Design

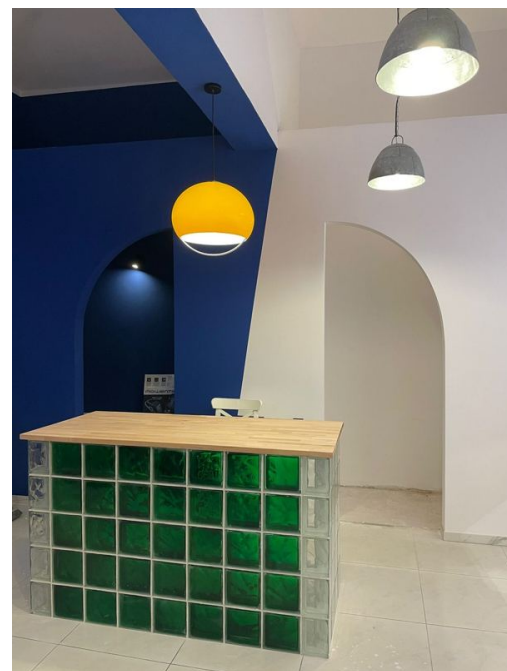


As built

3. Counter

Built differently: glass blocks with a wooden top

Shop floor. Curved counter with a red top and a ribbed grey front. Sockets and LED strip inside, as on the plan.

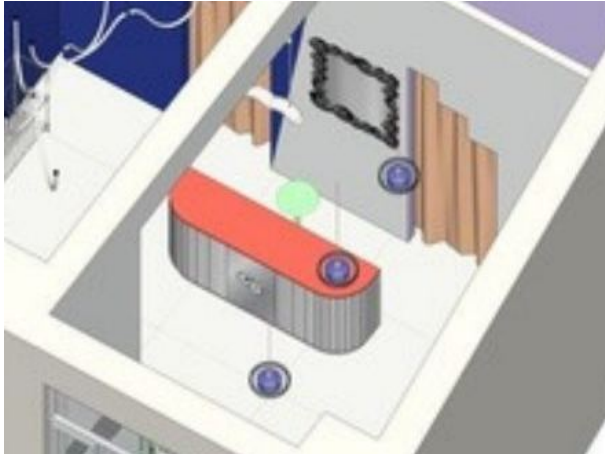

Design



As built

4. Curved bench

Built, waiting for Rachel

Shop floor. Plan in mm: 2830 long, 2167 deep, seat 440. Curves R460, R333, R845, R5786. Upholstery in the Canna Sapiens pattern.



Design



As built

5. Shelves with LED

Accepted

Right wall. Open shelves along the right wall, colours from the palette. LED strip in every shelf.



Design



As built